MISSISSIPPI
BOARD OF WATER COMMISSIONERS
416 North State Street
Jackson, Mississippi 39201

WATER WELL DRILLERS LOG

_____ 19_____ _____ _____
date well completed firm name county well located

LANDOWNER: _____

_____
(mailing address)

WELL LOCATION:

sec. ____ T ____ N/S R ____ E/W

____ miles ____ of ____
(distance) (direction) (nearest town)

WELL PURPOSE: _____
(home, irrigation, municipal, industrial)

WELL COMPLETION DATA:

(1) diameter (inches) _____

(2) total depth (feet) _____

(3) static water level (feet) _____ below/above top of ground.

(4) casing _____ (material), _____ (depth),

_____ (size) if telescope see back.

(5) screen _____ (length), _____ (depth to top)

_____ (size), _____ (material)

(6) pump _____ (HP) _____ (yield gpm)

_____ (type power)

(7) electric log _____ (yes or no)

_____ (organization running log)

(8) how well bottom plugged _____

DRILLERS REMARKS: _____

description of formations encountered	from	to
SHALE WITH SAND LENS	720	740
HARD SHALE	740	760
SHALE WITH SAND LENS	760	780
SHALE WITH SAND LENS	780	800
HARD SHALE	800	820
SHALE WITH SAND LENS	820	840
SHALE WITH SAND LENS	840	860
FINE SAND	860	880
SHALE WITH SAND LENS	880	900
SHALE WITH SAND LENS	900	920
SHALE WITH SAND LENS	920	940
SHALE WITH SAND LENS	940	960
SHALE WITH SAND LENS	960	980
SHALE WITH SAND LENS	980	1000
SNAD	1000	1020
HARD SHALE	1020	1040
HARD SHALE	1040	1060
HARD SHALE	1060	1080
HARD SHALE	1080	1100
HARD SHALE	1100	1120
HARD SHAEE	1120	1140
HARD SHALE	1140	1160
HARD SHALE	1160	1180
HARD SHALE	1180	1190

RECEIVED
DEC - 9 1974
MISS. BD. OF WATER COMM.

If well telescopes please sketch and show depths.

GROUND LEVEL

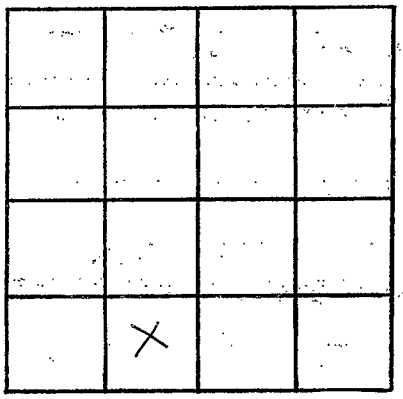

SECTION _____

Please indicate well location X.

ADDITIONAL INFORMATION

If more than one screen, show locations of each on sketch.