Yalobusha
A-2005

MISSISSIPPI
BOARD OF WATER COMMISSIONERS
416 North State Street
Jackson, Mississippi 39201

WATER WELL DRILLERS LOG

1-29-82 19 Austin Bain Well Service Yalobusha
date well completed firm name county well located

LANDOWNER: C.S. Simon
Lake Estate
Oakland Ms Hwy 32 E
(mailing address)

WELL LOCATION:
sec. 28 T 26 N/S R 6 E/W
5 (distance) miles E (direction) of Oakland (nearest town)

WELL PURPOSE: Home
(home, irrigation, municipal, industrial)

WELL COMPLETION DATA:

(1) diameter (inches) 4
(2) total depth (feet) 185
(3) static water level (feet) 80 (below) ~~above~~ top of ground.
(4) casing Pvc (material), 185 (depth),
_____ (size) if telescope see back.
(5) screen 10' (length), 175 (depth to top)
_____ (size), _____ (material)
(6) pump 3/4 (HP) 10 (yield gpm)
Elect (type power)
(7) electric log _____ (yes or no)
_____ (organization running log)
(8) how well bottom plugged Gravel Bottom

DRILLERS REMARKS:

description of formations encountered	from	to
Clay	0	18
Sand + Clay	18	60
Rock	60	61
Blue Clay	61	130
Rock	130	131
Blue Clay	131	145
Sand	145	185

DEPT. OF NATURAL RESOURCES
BUREAU OF LAND & WATER RESOURCES
MAR -8 1982
RECEIVED

If well telescopes please sketch and show depths.

GROUND LEVEL

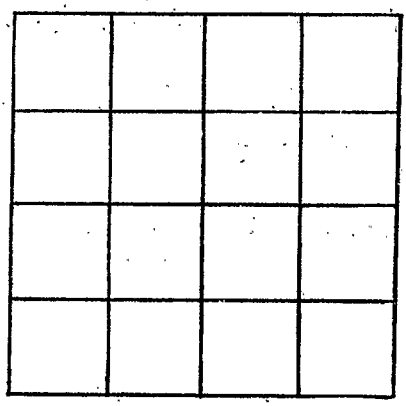

SECTION _____

Please indicate well location X.

ADDITIONAL INFORMATION

If more than one screen, show locations of each on sketch.