MISSISSIPPI DEPARTMENT OF ENVIRONMENTAL QUALITY
Bureau of Land and Water Resources

P. O. Box 10631
Jackson, MS 39289-0631

WATER WELL DRILLERS LOG

COUNTY WELL LOCATED: Yalabusha	
WELL NUMBER: 4	CODED: 2015
DATE WELL COMPLETED: 7/11/95	
PERMIT NUMBER	
NAME OF DRILLING FIRM: Lipe Well & Supply Co Pope MS. 38658	

NAME & MAILING ADDRESS OF LANDOWNER
Darlese Taylor
Lake Estates
Water Valley, MS.

WELL LOCATION: SEC 11 TOWNSHIP 11 N (S) RANGE 6 E (W)

DISTANCE 12 Miles DIRECTION W of NEAREST TOWN Water Valley

OTHER LANDMARK

WELL PURPOSE: (Home), Irrigation, Municipal, Industrial, Fish Pond, etc.

PUMP DATA

PUMP TYPE (Circle One): (Submersible), Turbine, Jet, Flowing Well, Other (Describe)

POWER TYPE (Circle One): (Electric), Tractor, Diesel, Gasoline, Butane, Other (Describe) H/P 3/4

Pump Capacity (GPM)	No. of Stages	Setting Depth
		FT.

PUMP TEST

Well yielded 10 GPM with a drawdown of 5 ft. after 1 hours of pumping

WELL DATA

Well Depth	Casing Diameter (In.)	Casing Length (Ft.)
160	4"	150

Type of Casing	Hole Depth	Depth to Static Water Level
PVC	160	60

TYPE OF COMPLETION: (Circle One or More): (Gravel Packed), Underreamed, Telescoped, Natural Development, Open Hole, Other (Describe)

Top of Lap Pipe or Reduction in Casing FEET

IF TELESCOPED OR MORE THAN ONE SCREEN: USE BACK PAGE

SCREEN DATA

Diameter - Inches	Length - Feet	Slot Size - Inches
4"	10	.013

Screen Type	Depth to Bottom - Feet
PVC	160

LOG DATA

TYPE OF LOG RUN (Circle One): (No Log Run), Electric, Gamma Ray, Density, Sonic, Neutron, Other (Describe)

Name of Organization Running Log

GEOLOGIC DATA (Office Use Only)

Surface Elev.	Geologic Unit	Unit Thickness	Depth to Top
Subs. SWL	Date	Analysis	Aquifer Test

Driller's Remarks

RECEIVED
JUN 11 1998
Dept. of Environmental Quality
Office of Land & Water Resources

DESCRIPTION OF FORMATIONS ENCOUNTERED	FROM	TO	FORMATIONS (Continued)	FROM	TO
top soil	0	20			
Clay, streaks of sand	20	40			
Brittle clay, streaks sand	40	60			
Brittle clay	60	80			
Brittle clay, sand, rock	100	120			
Clay	120	140			
Sand.	140	160			
			IF MORE SPACE IS NEEDED, USE BACK		

If well telescopes please
sketch and show depths.

GROUND LEVEL

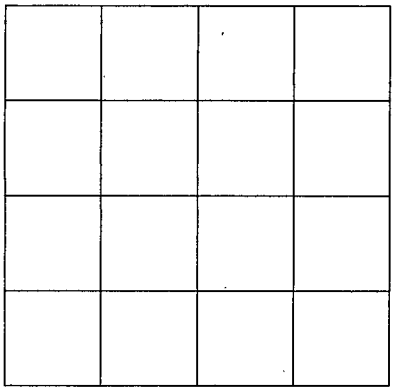

SECTION _____

Please indicate well location X.

ADDITIONAL INFORMATION

If more than one screen,
show location of each on sketch.