YALOBUSHA
E53
2/79
E log #66

MISSISSIPPI
BOARD OF WATER COMMISSIONERS
416 North State Street
Jackson, Mississippi 39201

CODED

# WATER WELL DRILLERS LOG

Feb 29 19 — Robert E Ratliff & Son — Yalobusha
date well completed — firm name — county well located

LANDOWNER: Tillatoba Water Assoc.

(mailing address)

WELL LOCATION:
sec. 32 T 25 (N) S R 4 (E) W
0 (distance) miles 0 (direction) of Tillatoba (nearest town)

WELL PURPOSE: Municipal
(home, irrigation, municipal, industrial)

WELL COMPLETION DATA:
(1) diameter (inches) 10 x 4
(2) total depth (feet) 1020
(3) static water level (feet) 149 (below) above top of ground.
(4) casing Steel (material), 950 (depth),
10 (size) if telescope see back.
(5) screen 40' (length), 980 (depth to top)
4 (size), SS (material)
(6) pump 30 (HP) 100 (yield gpm)
Electric (type power)
(7) electric log Yes (yes or no)
State (organization running log)
(8) how well bottom plugged BPO

DRILLERS REMARKS:

| description of formations encountered | from | to |
|---|---|---|
| Top Soil & Clay | 0 | 10 |
| Clay & Sand streaks | 10 | 600 |
| Clay & Sand Streaks | 600 | 850 |
| Sand | 850 | 900 |
| Clay | 900 | 950 |
| Sand | 950 | 1040 |

CODED

Miss. Board of Water Comm.

SEP 12 1979

RECEIVED

telescopes please
sketch and show depths.

GROUND LEVEL

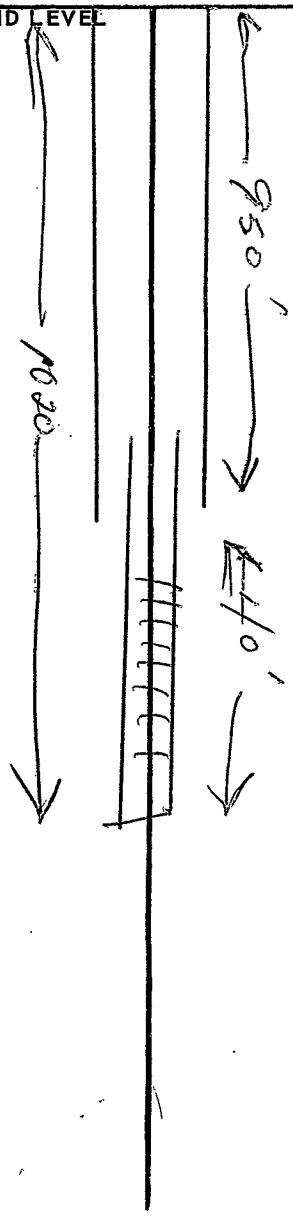


If more than one screen,
show locations of each on sketch.

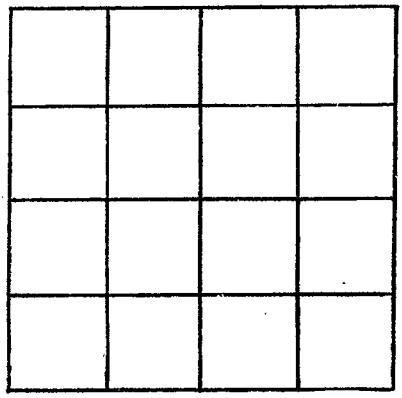

SECTION _____

Please indicate well location X.

ADDITIONAL INFORMATION