YALOBUSHA
F4
6-15-73

MISSISSIPPI
BOARD OF WATER COMMISSIONERS
416 North State Street
Jackson, Mississippi 39201

CODED

WATER WELL DRILLERS LOG

6-15 1973 James R. Lipe Yalobusha
date well completed — firm name — county well located

LANDOWNER: Whit Hight
Coffeeville Miss.
(mailing address)

WELL LOCATION:
sec. 10 T 25 (N) S R 5 (E) W
5 miles (distance) West (direction) of Coffeeville (nearest town)

WELL PURPOSE:
(home), irrigation, municipal, industrial)

WELL COMPLETION DATA:

(1) diameter (inches) 4
(2) total depth (feet) 152
(3) static water level (feet) 90 below above top of ground.
(4) casing PVC (material), 142 (depth),
4 (size) if telescope see back.
(5) screen 10 (length), 142 (depth to top)
4 (size), PVC (material)
(6) pump 3/4 (HP) 10 (yield gpm)
elec. (type power)
(7) electric log no (yes or no)
no (organization running log)
(8) how well bottom plugged PVC Plug

DRILLERS REMARKS:

description of formations encountered	from	to
Clay	0	20
Red Sand	20	40
" "	40	60
Clay	60	80
"	80	100
"	100	120
Sand	120	152

CODED

JUN 5 1973

If well telescopes please sketch and show depths.

GROUND LEVEL

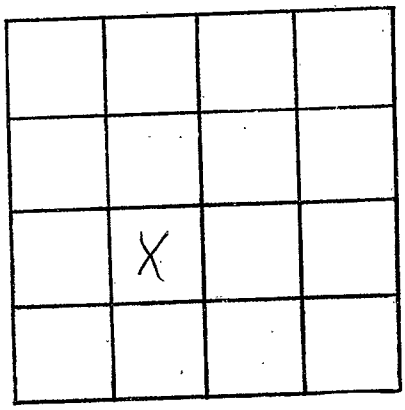

SECTION 10

Please indicate well location X.

ADDITIONAL INFORMATION

If more than one screen, show locations of each on sketch.