

VADOBASHA
 F 2005

MISSISSIPPI DEPARTMENT OF NATURAL RESOURCES
 Bureau of Land and Water Resources
 Southport Mall
 P.O. Box 10631
 Jackson, Mississippi 39209
WATER WELL DRILLERS LOG

8-22 1990 date well completed Pipe Well + Supply Co., Inc. firm name VADOBASHA county well located

LANDOWNER: ADAM Golden
Box 772
Lambert, MS.
 (mailing address)

WELL LOCATION:
 sec. 17 T 25 N R 5 E
8 miles EAST of OAKLAND
 (distance) (direction) (nearest town)


WELL PURPOSE: HOME
 (home, irrigation, municipal, industrial)

WELL COMPLETION DATA:

- (1) diameter (inches) 4"
- (2) total depth (feet) 180
- (3) static water level (feet) _____ below above top of ground.
- (4) casing PVC, 170,
 (material) (depth)
4 if telescope see back.
 (size)
- (5) screen 10, 170
 (length) (depth to top)
4", PVC
 (size) (material)
- (6) pump 3/4 _____
 (HP) (yield gpm)
electric
 (type power)
- (7) electric log _____
 (yes or no)

 (organization running log)
- (8) how well bottom plugged: capped

description of formations encountered	from	to
CLAY	0	20
clay, rock, little sand	20	40
little sand - back to clay	40	80
clay - hard clay	60	80
Hard clay	80	100
Hard clay	100	120
Hard clay - streaks of sand	120	140
clay - streaks of sand	140	160
clay - sand - clay	160	180

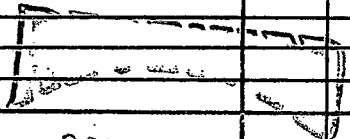


001 95 19811

Department of Natural Resources
 Bureau of Land & Water Resources

DRILLERS REMARKS:

If well telescopes please sketch and show depths.

GROUND LEVEL

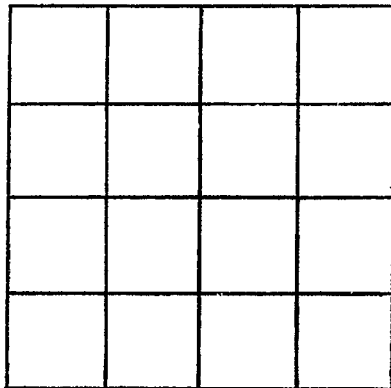

SECTION _____

Please indicate well location X.

ADDITIONAL INFORMATION

If more than one screen,
show locations of each on sketch.