YALOBUSHA
H 2000
6-29-77

MISSISSIPPI
BOARD OF WATER COMMISSIONERS
416 North State Street
Jackson, Mississippi 39201

WATER WELL DRILLERS LOG

6-29 date well completed 1977 Lipe Well Co. firm name Yalobusha county well located

LANDOWNER: Duard Davis
Coffeeville Ms. (mailing address)

WELL LOCATION:
sec. 18 T 25 (N) S R 7 (E) W
1 7½ (distance) miles South (direction) of Watervalley (nearest town)

WELL PURPOSE:
(home) irrigation, municipal, industrial)

WELL COMPLETION DATA:

(1) diameter (inches) 4
(2) total depth (feet) 215
(3) static water level (feet) 80 below above top of ground.
(4) casing PVC (material), 203 (depth),
4 (size) if telescope see back.
(5) screen 12 (length), 203 (depth to top)
4 (size), PVC (material)
(6) pump 3/4 (HP) 10 (yield gpm)
elec (type power)
(7) electric log non (yes or no)
non (organization running log)
(8) how well bottom plugged PVC plug

DRILLERS REMARKS:

description of formations encountered	from	to
Top Soil	0	20
sand	20	50
clay	50	120
sand and clay	120	160
" " "	160	180
good sand	180	215

RECEIVED
JUL 8 - 1977
MISS. BD. OF WATER COMM.

If well telescopes please sketch and show depths.

GROUND LEVEL

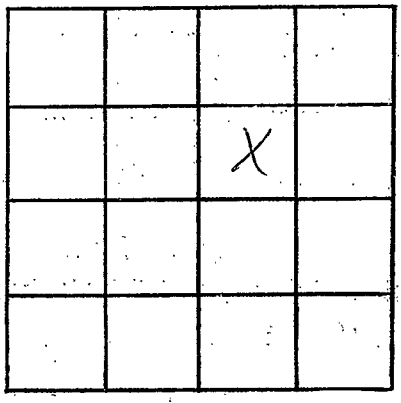

SECTION 18

Please indicate well location X.

ADDITIONAL INFORMATION

If more than one screen, show locations of each on sketch.