Yalobusha
J 23
6-28-75

MISSISSIPPI
BOARD OF WATER COMMISSIONERS
416 North State Street
Jackson, Mississippi 39201

CODED

WATER WELL DRILLERS LOG

6-28-19 75 Lipe Well Co. Yalobusha
date well completed — firm name — county well located

LANDOWNER: J. W. Howell
Scobey Miss.
(mailing address)

WELL LOCATION: 15F
sec. 31 T 24 (N) S R 4 (E) W
3 (distance) miles West (direction) of Scobey (nearest town)

WELL PURPOSE: (home), irrigation, municipal, industrial

WELL COMPLETION DATA:

(1) diameter (inches) 4
(2) total depth (feet) 110
(3) static water level (feet) 90 below above top of ground.
(4) casing PVC (material), 100 (depth), 4 (size) if telescope see back.
(5) screen 10 (length), 100 (depth to top), 4 (size), PVC (material)
(6) pump 3/4 (HP) 10 (yield gpm) elec. (type power)
(7) electric log no (yes or no)
no (organization running log)
(8) how well bottom plugged PVC cap

DRILLERS REMARKS:

description of formations encountered	from	to
Top Soil	0	20
Sand	20	40
Gravel	40	60
"	60	80
Pea gravel	80	100
" "	100	110

RECEIVED
JUL 14 1975
MISS. BD. OF WATER COMM.

If well telescopes please sketch and show depths.

GROUND LEVEL

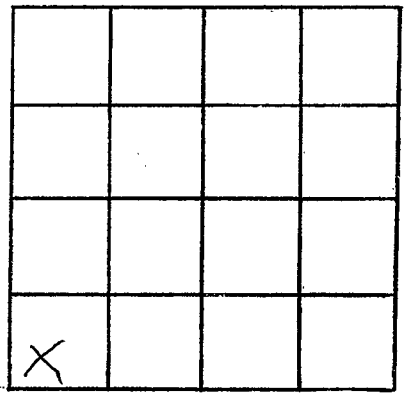

SECTION 31

Please indicate well location X.

ADDITIONAL INFORMATION

If more than one screen, show locations of each on sketch.