

YALO.

MISSISSIPPI BOARD OF WATER COMMISSIONERS

OL 35  
10-8-65

WATER WELL DRILLERS LOG

CODED

CODED

Date: 10-8, 1965, Driller: Garry Robinson County Parola  
(Name)

- (1) Owner of Land: Mr. Davis  
(Name)  
Water Valley, Miss  
(Address)
- (2) Location:  $\frac{1}{4}$ , 14,  $\frac{246$  Sec. T 4 R 6  
4 miles W of W. H. Hays  
(distance) (direction) (Nearest Town)
- (3) Topography: ✓  
(Hilly) (Flat) (Level)
- (4) Purpose of Well: Home  
(Domestic Irrigation  
Municipal, Industrial, Other)

Description & Color of Materials  
Sand, Clay, Red Clay, Shell, etc.

Thick-  
ness  
Feet

Depth  
Feet

<u>Clay</u>	<u>0</u>	<u>20</u>
<u>Sand &amp; Clay</u>	<u>20</u>	<u>50</u>
<u>Sand</u>	<u>50</u>	<u>80</u>

Information upon completion of well:


- (1) Diameter 2 inches.
- (2) Total Depth 80 feet.
- (3) Water Level 40 feet below top of ground.
- (4) Cased to 75, Size 2 in
- (5) Screen: Size 3 in, Length 5 ft.
- (6) Were any formations sealed against pollution?  
\_\_\_\_\_ yes, \_\_\_\_\_ no.

If YES depth of formation \_\_\_\_\_

Why \_\_\_\_\_

Drillers Remarks: Plastic well

outside screens

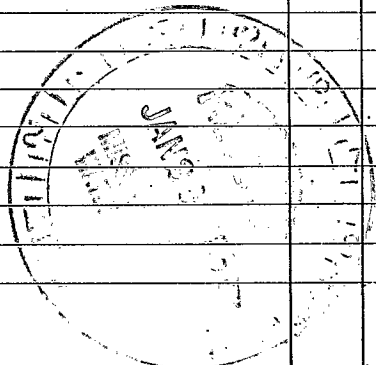

(Use Back Side)

Well No.

