C 17588

Yazoo
A 18
5-27-75

MISSISSIPPI
BOARD OF WATER COMMISSIONERS
416 North State Street
Jackson, Mississippi 39201

CODED

WATER WELL DRILLERS LOG

May 27, 1975 Singer-Layne Central Div. Yazoo
date well completed — firm name — county well located

LANDOWNER: Galloway & Whitsitt
502 Wister Drive
Belzoni, MS
(mailing address)

WELL LOCATION:
sec. 8 T 13 N/S R 2 W/E 155
1 (distance) miles south (direction) of Carter (nearest town)

WELL PURPOSE: (home, irrigation, municipal, industrial)

WELL COMPLETION DATA:
(1) diameter (inches) 16"
(2) total depth (feet) 111'
(3) static water level (feet) 17 below/above top of ground.
(4) casing steel (material), 61' (depth), 16" (size) if telescope see back.
(5) screen 50' (length), 61' (depth to top), 16" (size), steel (material)
(6) pump 60 (HP) 2800-3000 (yield gpm) engine (type power)
(7) electric log no (yes or no)
(organization running log)
(8) how well bottom plugged with plate

DRILLERS REMARKS:

description of formations encountered	from	to
Clay	0	12
Blue Clay	12	25
Blue Clay and Sand	25	37
Sand	37	58
Coarse Sand	58	66
Coarse Sand & Pea Gravel	66	74
Coarse Sand	74	103
Coarse Sand & Pea Gravel	103	109
Coarse Sand & Gravel	109	111

RECEIVED
JUN 12 1975
MISS. BD. OF WATER COMM.

If well telescopes please sketch and show depths.

GROUND LEVEL

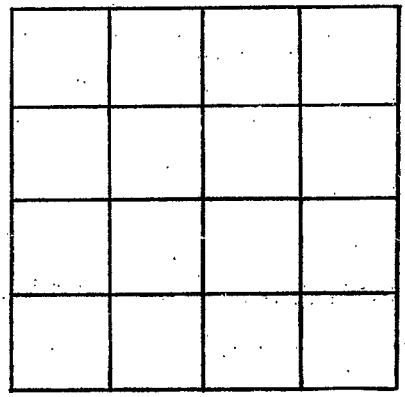

SECTION _____

Please indicate well location X.

ADDITIONAL INFORMATION

If more than one screen, show locations of each on sketch.