YAZOO
B22
5-31-72

CODED
CODED
014653-3837R

MISSISSIPPI
BOARD OF WATER COMMISSIONERS
416 North State Street
Jackson, Mississippi 39201

WATER WELL DRILLERS LOG

May 31, 1972 19 — date well completed
Singer-Layne Central Division — firm name
Yazoo — county well located

LANDOWNER: Eden Fisheries, Inc.
Yazoo City, Mississippi
(mailing address)

WELL LOCATION:
sec. 8 T 13 N R 1 E W
4 (distance) miles west (direction) of Eden (nearest town)

WELL PURPOSE: irrigation
(home, irrigation, municipal, industrial)

WELL COMPLETION DATA:

(1) diameter (inches) 16
(2) total depth (feet) 108
(3) static water level (feet) 24' below top of ground.
(4) casing steel (material), 58' (depth),
16" (size) if telescope see back.
(5) screen 50' (length), 108' (depth to top)
16" (size), Armco (material)
(6) pump 100 (HP) 3000 (yield gpm)
engine (type power)
(7) electric log no (yes or no)
(organization running log)
(8) how well bottom plugged plate

DRILLERS REMARKS:

description of formations encountered	from	to
Clay	0	38
Coarse sand, pea gravel	38	60
Coarse sand, gravel	60	112

CODED

JUN 20 1972
ASS. BD. OF
WATER COMM.

If well telescopes please sketch and show depths.

GROUND LEVEL

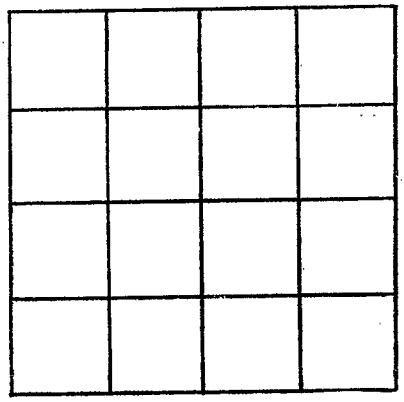

SECTION _____

Please indicate well location X.

ADDITIONAL INFORMATION

If more than one screen, show locations of each on sketch.