MISSISSIPPI DEPARTMENT OF ENVIRONMENTAL QUALITY
Office of Land and Water Resources

P. O. Box 10631
Jackson, MS 39289-0631
WATER WELL DRILLERS LOG

COUNTY WELL LOCATED: YAZOO
WELL NUMBER: D-2003 | CODED:
DATE WELL COMPLETED: MARCH 28, 2000

PERMIT NUMBER:
NAME OF DRILLING FIRM: F.M. BUD CRESSWELL
BENTONIA, MS -

NAME & MAILING ADDRESS OF LANDOWNER: J. D. MORROW
PICKENS, MS -

WELL LOCATION: SEC 19 TOWNSHIP 12 N RANGE 3 E

DISTANCE 4 Miles DIRECTION WEST NEAREST TOWN PICKENS

OTHER LANDMARK:

WELL PURPOSE: Home, Irrigation, Municipal, Industrial, Fish Pond, etc.

PUMP DATA

PUMP TYPE (Circle One): Submersible, Turbine, Jet, Flowing Well, Other (Describe)

POWER TYPE (Circle One): Electric, Tractor, Diesel, Gasoline, Butane, Other (Describe) H/P 3

Pump Capacity (GPM)	No. of Stages	Setting Depth
40	14	147 FT.

PUMP TEST

Well yielded 75 GPM with a drawdown of 20 ft. after 1 hours of pumping

WELL DATA

Well Depth	Casing Diameter (In.)	Casing Length (Ft.)
260	4	220

Type of Casing	Hole Depth	Depth to Static Water Level
PVC	260	60

TYPE OF COMPLETION: (Circle One or More): Gravel Packed, Underreamed, Telescoped, Natural Development, Open Hole, Other (Describe)

WELL GROUTED TO A DEPTH OF 25 FEET
Type Grout (circle one): Cement, Bentonite, or Mix

LOG DATA

TYPE OF LOG RUN (Circle One): No Log Run, Electric, Gamma Ray, Density, Sonic, Neutron, Other (Describe)

Name of Organization Running Log

GEOLOGIC DATA (Office Use Only)

Surface Elev	Geologic Unit	Unit Thickness	Depth to Top
Subs. SWL	Date	Analysis	Aquifer Test

Driller's Remarks

SCREEN DATA

Diameter - Inches	Length - Feet	Slot Size - Inches
4	40	.016

Screen Type	Depth to Bottom - Feet
PVC	260

Top of Lap Pipe or Reduction in Casing FEET (IF TELESCOPED OR MORE THAN ONE SCREEN: USE BACK PAGE)

RECEIVED APR 17 2000 Dept. of Environmental Quality Office of Land & Water Resources

DESCRIPTION OF FORMATIONS ENCOUNTERED	FROM	TO
SURFACE DEPOSITS	0	10
GREY CLAY	10	50
SANDY SHALE	50	215
SAND	215	260

FORMATIONS (Continued)	FROM	TO

IF MORE SPACE IS NEEDED, USE BACK

If well telescopes please
sketch and show depths.

GROUND LEVEL

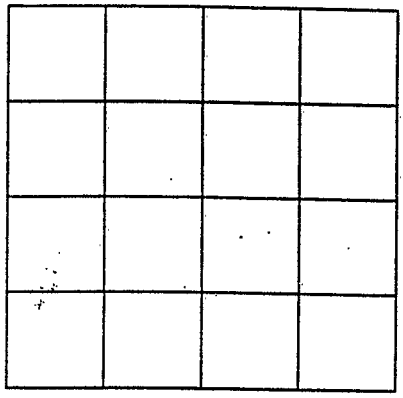

SECTION _____

Please indicate well location X.

ADDITIONAL INFORMATION

If more than one screen,
show location of each on sketch.