MISSISSIPPI DEPARTMENT OF ENVIRONMENTAL QUALITY
Bureau of Land and Water Resources

P. O. Box 10631
Jackson, MS 39289-0631
WATER WELL DRILLERS LOG

COUNTY WELL LOCATED: Yazoo	
WELL NUMBER: K 59	CODED: ✓
DATE WELL COMPLETED: 5-27-98	
PERMIT NUMBER	
NAME OF DRILLING FIRM: Griner Drilling Service, Inc.	

NAME & MAILING ADDRESS OF LANDOWNER
CNG Producing Company
CNG Tower 1450 Poydras St.
New Orleans, LA 70112-6000

WELL LOCATION: SEC 2 TOWNSHIP 11 (N) S RANGE 3 E (W)

DISTANCE 5 Miles DIRECTION NW of NEAREST TOWN Yazoo City

OTHER LANDMARK
1500' N + 2317' E of SW Cor

WELL PURPOSE: Home, Irrigation, Municipal, Industrial, Fish Pond, etc.
Oilfield Supply Well

PUMP DATA

PUMP TYPE (Circle One):
Submersible, Turbine, Jet, Flowing Well,
Other (Describe) None Installed - Airlift

POWER TYPE (Circle One):
Electric, Tractor, Diesel, Gasoline, Butane,
Other (Describe) _____ H/P _____

Pump Capacity (GPM)	No. of Stages	Setting Depth
Bowed well		FT.

PUMP TEST
Well yielded 120 GPM with
a drawdown of _____ ft.
after _____ hours of pumping

WELL DATA

Well Depth	Casing Diameter (In.)	Casing Length (Ft.)
120	4	90
Type of Casing	**Hole Depth**	**Depth to Static Water Level**
PVC	120	15

TYPE OF COMPLETION: (Circle One or More):
(Gravel Packed), Underreamed, Telescoped,
Natural Development, Open Hole, Other
(Describe) _____

Top of Lap Pipe or Reduction in Casing
FEET
IF TELESCOPED OR MORE THAN ONE SCREEN: USE BACK PAGE

LOG DATA

TYPE OF LOG RUN (Circle One): (No Log Run)
Electric, Gamma Ray, Density, Sonic, Neutron,
Other (Describe) _____

Name of Organization Running Log

GEOLOGIC DATA (Office Use Only)

Surface Elev.	Geologic Unit	Unit Thickness	Depth to Top
Subs. SWL	Date	Analysis	Aquifer Test

Driller's Remarks

SCREEN DATA

Diameter - Inches	Length - Feet	Slot Size - Inches
4	30	.010
Screen Type		**Depth to Bottom - Feet**
PVC		120

DESCRIPTION OF FORMATIONS ENCOUNTERED	FROM	TO	FORMATIONS (Continued)	FROM	TO
Clay	0	10			
Sand	10	55			
Clay	55	60			
Sand	60	120			
			05-29-98A09:26 RCVD		
			IF MORE SPACE IS NEEDED, USE BACK		

If well telescopes please
sketch and show depths.

GROUND LEVEL

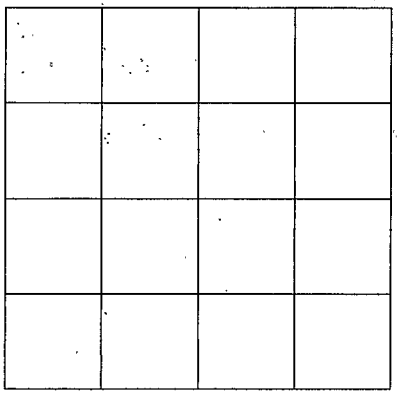

SECTION _____

Please indicate well location X.

ADDITIONAL INFORMATION

If more than one screen,
show location of each on sketch.