YA200
L22
4-4-72

MISSISSIPPI
BOARD OF WATER COMMISSIONERS
416 North State Street
Jackson, Mississippi 39201

CODED

WATER WELL DRILLERS LOG

April 4 1972 E.M. "Bud" Bessuel YA200
date well completed — firm name — county well located

LANDOWNER: B. D. Harris
Yazoo City, Miss.
(mailing address)

WELL LOCATION:
sec. 25 T 11 N R 2 E W
5 miles South of YA200
(distance) (direction) (nearest town)

WELL PURPOSE: Home
(home, irrigation, municipal, industrial)

WELL COMPLETION DATA:

(1) diameter (inches) 2
(2) total depth (feet) 580
(3) static water level (feet) 220 below ~~above~~ top of ground.
(4) casing Steel (material), 560 (depth), 2 (size) if telescope see back.
(5) screen 20 (length), 560 (depth to top), 2 (size), Stainless (material)
(6) pump Air Compressor (HP) (yield gpm)
0 (type power)
(7) electric log No (yes or no)
— (organization running log)
(8) how well bottom plugged Steel plug

DRILLERS REMARKS:

description of formations encountered	from	to
Clay	0	30
Sand	30	90
Clay	90	420
Shale	420	470
Sand	470	580

CODED

APR 6 1972

If well telescopes please sketch and show depths.

GROUND LEVEL

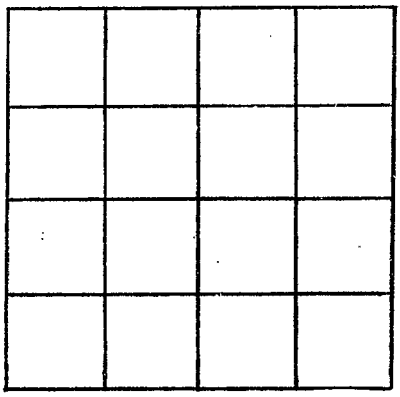

SECTION _____

Please indicate well location X.

ADDITIONAL INFORMATION

If more than one screen, show locations of each on sketch.