Yazoo
P 2014

MISSISSIPPI DEPARTMENT OF NATURAL RESOURCES
Bureau of Land and Water Resources
Southport Mall
P.O. Box 10631
Jackson, Mississippi 39209

WATER WELL DRILLERS LOG

June 17 1986 — date well completed
E.M. "Bud" Cresswell — firm name
Yazoo — county well located

LANDOWNER:
Warren Davis Jr.
Yazoo City, MS. 39194
(mailing address)

WELL LOCATION:
sec. 34 T 10 N R 4 W
2 (distance) miles South (direction) of Satartia (nearest town)

WELL PURPOSE: Home
(home, irrigation, municipal, industrial)

WELL COMPLETION DATA:

(1) diameter (inches) 4
(2) total depth (feet) 580
(3) static water level (feet) 6 below ~~above~~ top of ground.
(4) casing PVC (material), 540 (depth), 4 (size) If telescope see back.
(5) screen 40 (length), 540 (depth to top), 4 (size), PVC (material)
(6) pump 1 (HP) 20 (yield gpm)
(type power)
(7) electric log No (yes or no)
(organization running log)
(8) how well bottom plugged Rock wash

DRILLERS REMARKS:

description of formations encountered	from	to
Surface	0	30
Sand - gravel	30	85
blue clay	85	420
Sandy - shale	420	500
Sand	500	580

RECEIVED
JUN 25 1986
Department of N
Bureau of Land & W

If well telescopes please sketch and show depths.

GROUND LEVEL

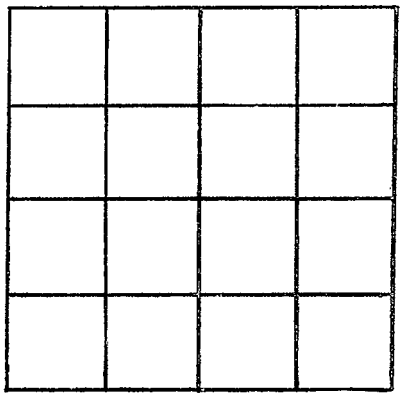

SECTION _____

Please indicate well location X.

ADDITIONAL INFORMATION

If more than one screen, show locations of each on sketch.