Yazoo
Q 17
5-19-81

MISSISSIPPI DEPARTMENT OF NATURAL RESOURCES

Bureau of Land and Water Resources
Southport Mall
P.O. Box 10631
Jackson, Mississippi 39209

Ryen

WATER WELL DRILLERS LOG

5 / 19 / 19 81 — date well completed
~~Barnes~~ Bros. — firm name
Yazoo — county well located

LANDOWNER: Barnes Bros.

Satartia, MS.
(mailing address)

WELL LOCATION:
sec. 17 T 10 (N) S R 3 E (W)
3 (distance) miles N (direction) of Satartia (nearest town)

WELL PURPOSE:
(home, irrigation, municipal, industrial)

WELL COMPLETION DATA:

(1) diameter (inches) 16"
(2) total depth (feet) 124'-0"
(3) static water level (feet) 19' below above top of ground.
(4) casing Steel (material), 124' (depth),
16" (size) If telescope see back.
(5) screen 40' (length), 84' (depth to top)
16" (size), Steel (material)
(6) pump 125 (HP) 1200 (yield gpm)
Diesel (type power)
(7) electric log _____ (yes or no)
_____ (organization running log)
(8) how well bottom plugged plate

DRILLERS REMARKS: _____

description of formations encountered CODED	from	to
Clay	0	22
Sand	22	83
Sand & gravel	83	124

CODED

JUN 1981
RECEIVED

9

If well telescopes please sketch and show depths.

GROUND LEVEL

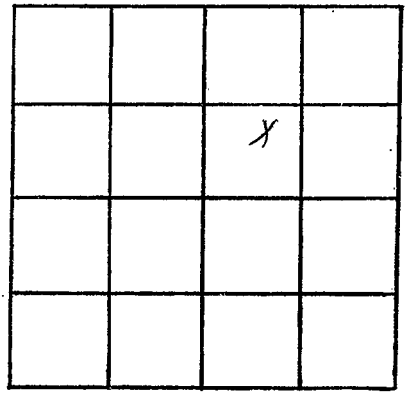

SECTION 12

Please indicate well location X.

ADDITIONAL INFORMATION

If more than one screen, show locations of each on sketch.