Yazoo
U 78
7-15-81

MISSISSIPPI DEPARTMENT OF NATURAL RESOURCES

Bureau of Land and Water Resources
Southport Mall
P.O. Box 10631
Jackson, Mississippi 39209

CODED

WATER WELL DRILLERS LOG

July 15 1981 — date well completed
Larry's Well & Pump — firm name
Yazoo — county well located

LANDOWNER: Dixie Farms
"
Satartia, Mo
(mailing address)

WELL LOCATION:
sec. 6 T 9 N R 4 E W
9 miles SW of Satartia
(distance) (direction) (nearest town)

WELL PURPOSE: Irrigation
(home, irrigation, municipal, industrial)

WELL COMPLETION DATA:

(1) diameter (inches) 16
(2) total depth (feet) 104'
(3) static water level (feet) 13 below / above top of ground.
(4) casing Steel (material), 64' (depth),
16 (size) if telescope see back.
(5) screen 40 (length), 64' (depth to top)
16 (size), Steel (material)
(6) pump 60 (HP) 300 (yield gpm)
(type power)
(7) electric log No (yes or no)
(organization running log)
(8) how well bottom plugged Steel Plate

DRILLERS REMARKS:

description of formations encountered	from	to
CLAY	0	65
FINE SAND	65	75
CORSE SAND	75	104

CODED

DEPT. OF NATURAL RESOURCES
BUREAU OF LAND & WATER RESOURCES
OCT 19 1981
RECEIVED

If well telescopes please sketch and show depths.

GROUND LEVEL

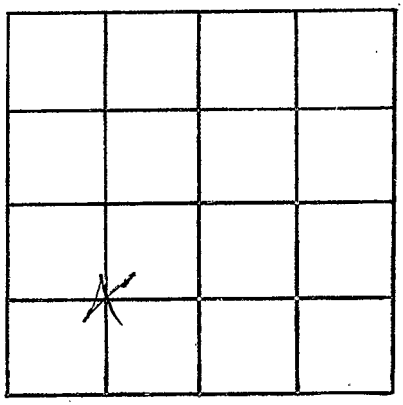

SECTION 6

Please indicate well location X.

ADDITIONAL INFORMATION

If more than one screen, show locations of each on sketch.