22-4235

MISSISSIPPI DEPARTMENT OF NATURAL RESOURCES

Bureau of Land and Water Resources

P.O. Box 10631
Jackson, Mississippi 39209

WATER WELL DRILLERS LOG

CODED

COUNTY WELL LOCATED	YAZOO
WELL NUMBER	U84
CODED	207
DATE WELL COMPLETED	5-3-89
PERMIT NUMBER	MS-GW-11819
NAME OF DRILLING FIRM	Layne-Central Co. Cleveland, MS

NAME & MAILING ADDRESS OF LANDOWNER
Dixie Farms
River Route - Box 44
Sartartia, MS 39162

WELL LOCATION: SEC 2 TOWNSHIP 9 N ~~S~~ RANGE 5 ~~E~~ W

DISTANCE 6 Miles DIRECTION NW of NEAREST TOWN Sartartia

OTHER LANDMARK

WELL PURPOSE: Home, Irrigation, Municipal, Industrial, Fish Pond, etc.
Irrigation

PUMP DATA

PUMP TYPE (Circle One): Submersible, (Turbine), Jet, Flowing Well, Other (Describe) ____

POWER TYPE (Circle One): Electric, Tractor, (Diesel), Gasoline, Butane, Other (Describe) ____ H/P ____

Pump Capacity (GPM)	No. of Stages	Setting Depth
1200	4	70 FT.

PUMP TEST

Well yielded Not Tested GPM with a drawdown of ____ ft. after ____ hours of pumping

WELL DATA

Well Depth	Casing Diameter (In.)	Casing Length (Ft.)
124	16	74

Type of Casing	Hole Depth	Depth to Static Water Level
Steel	124	15

TYPE OF COMPLETION: (Circle One or More): (Gravel Packed), Underreamed, Telescoped, Natural Development, Open Hole, Other (Describe) ____

Top of Lap Pipe or Reduction in Casing FEET

IF TELESCOPED OR MORE THAN ONE SCREEN: USE BACK PAGE

LOG DATA

TYPE OF LOG RUN (Circle One): (No Log Run), Electric, Gamma Ray, Density, Sonic, Neutron, Other (Describe) ____

Name of Organization Running Log

GEOLOGIC DATA (Office Use Only)

Surface Elev.	Geologic Unit	Unit Thickness	Depth to Top
Subs. SWL	Date	Analysis	Aquifer Test

Driller's Remarks

RECEIVED
JUN 6 1990
Department of Natural Resources
Bureau of Land & Water Resources

SCREEN DATA

Diameter - Inches	Length - Feet	Slot Size - Inches
16	50	.060

Screen Type	Depth to Bottom - Feet
Steel	124

DESCRIPTION OF FORMATIONS ENCOUNTERED	FROM	TO
Clay	0	16
Fine Sand	16	50
Med. Sand	50	70
Coarse Sand	70	95
C. Sand & Pea Gravel	95	124

FORMATIONS (Continued)	FROM	TO

IF MORE SPACE IS NEEDED, USE BACK

If well telescopes please
sketch and show depths.

GROUND LEVEL

 

If more than one screen,
show location of each on sketch.

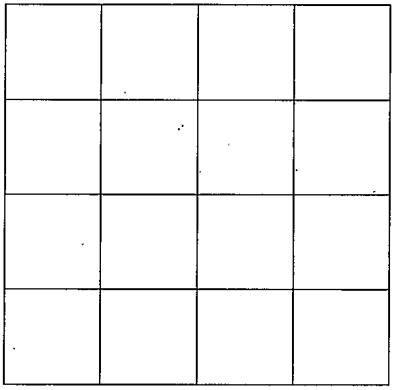

SECTION _____

Please indicate well location X.

ADDITIONAL INFORMATION