Friars Point Quad ELEV 166'

Friars Point

Z6

1/81 WTO

Recorded by JHH

Date 9-16-82

U.S. GEOLOGICAL SURVEY
WATER RESOURCES DIVISION
MISSISSIPPI DISTRICT
WELL RECORD

Well No. D-~~208~~

E-Log No.

County Coahoma

Site ID 34164309041590 1 | R=0* | T=A* | 2=W*

GEN. SITE DATA

Data reliab. 3=C* | C U | Report. agency 4=USGS* | Dist. 6=28* | 7=28* | Co. 8=027*

Lat. Long./ 9=341643* | 10=0904159* | Well No. 12='D026'*

Location 13=NW NE S27 T28N R05W* (SE NE) | Alt. 16=166.*

Hyd. Unit(OWDC) 20=* | Date 21=09/16/1982*

Well use 23=W* | Water Use 24=I* | Hole depth 27=*.* | Well depth 28=110.*

WL 30=16.* | Date 31=09/16/1982* | Source 33=5*

Status 273=* | Project No. 5=*

OWNER

R=158* | T=A* | Date 159#09/16/1982* | Owner No.

Owner 161#GARY WILLIAMS*

Rte 1 Box 294 Clarksdale

FIELD QW

R=192* | T=A* | Date 193#*.*.* | Temp. 196#00010* | 197=*

R=192* | T=A* | Date 193#*.*.* | Cond. 196#00095* | 197=*

R=192* | T=A* | Date 193#*.*.* | pH 196#00400* | 197=*

CONSTR.

R=58* | T=A* | 59#1* | Date 60=01/01/1982* | Remarks

Drlg. 63=* | Name | Method 65=R* | Finish 66=S*

CASING

R=76* | T=A* | 59#1*

Top csgn. 77#0.* | Bot. csng. 78=*.* | Diam. 79#16.*

R=76* | T=A* | 59#1*

Top csng 77#*.* | Bot. csgn. 78=*.* | Diam. 79#*.*

OPENINGS

R=82* | T=A* | 59#1* | Top 83#*.* | Bottom 84=*.*

Type 85=* | Diam. 87=*.* | Size 88=*.*

R=82* | T=A* | 59#1* | Top 83#*.* | Bottom 84=*.*

Type 85=* | Diam. 87=*.* | Size 88=*.*

YIELD

R=* | T=A* | 147#1* | Q 150=*.* | Q/S 272=*.*

134 flows 146 pumped

LIFT

R=42* | T= A * | Lift type 43# T * | Intake 44= * | Power type 45= *

Date 38= 09/16/1982 * | H.P. 46= *

LOGS

R=198* | T= A * | Log 199# * | Top 200= * | Bot 201= *

R=198* | T= A * | Log 199# * | Top 200= * | Bot 201= *

R=189* | T= A * | E Log No. 190# * | 191= M I S S D I S T *

ANAL.

R=114* | T= A * | Year 115# * | 117= * | 120= *

AQUIFERS

R=90* | T= A * | 256# 1 * | Top 91= * | Bot 92= *

Unit ID 93= 1.1.2.MRVA * | Name of Unit Alluvium

R=90* | T= A * | 256# 1 * | Top 91= * | Bot 92= *

Unit ID 93= * | Name of Unit

HYDRAULICS

R=98* | T= A * | 99# 1 * | Unit tested 100= * | 103= *

R=105* | T= A * | 99# 1 * | Test No. 106# * |

107= * | Transmissivity (gal/d)/ft

108= * | Hydraul. cond. (gal/d)/ft^2

110= * | Storage coeff. | Boundaries

R=121* | T= A * | Yr Begin 122# 1982 * | Network 258 # *

Water Level Data Collection (1)

9-16-82 JHH

Hole 30.00

Cut 10.65 ✓ Am

19.35

M.P. 3.40

15.95'

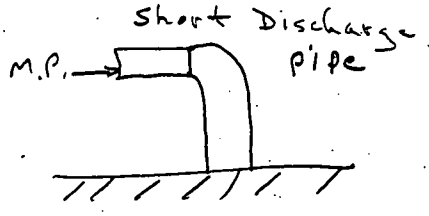

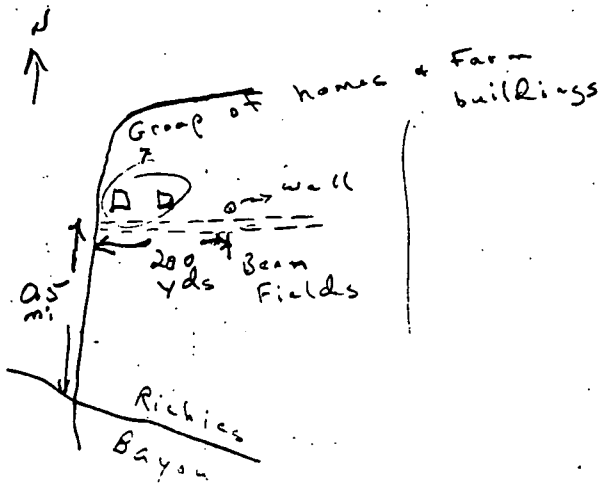

$E_s = (+150.05')$

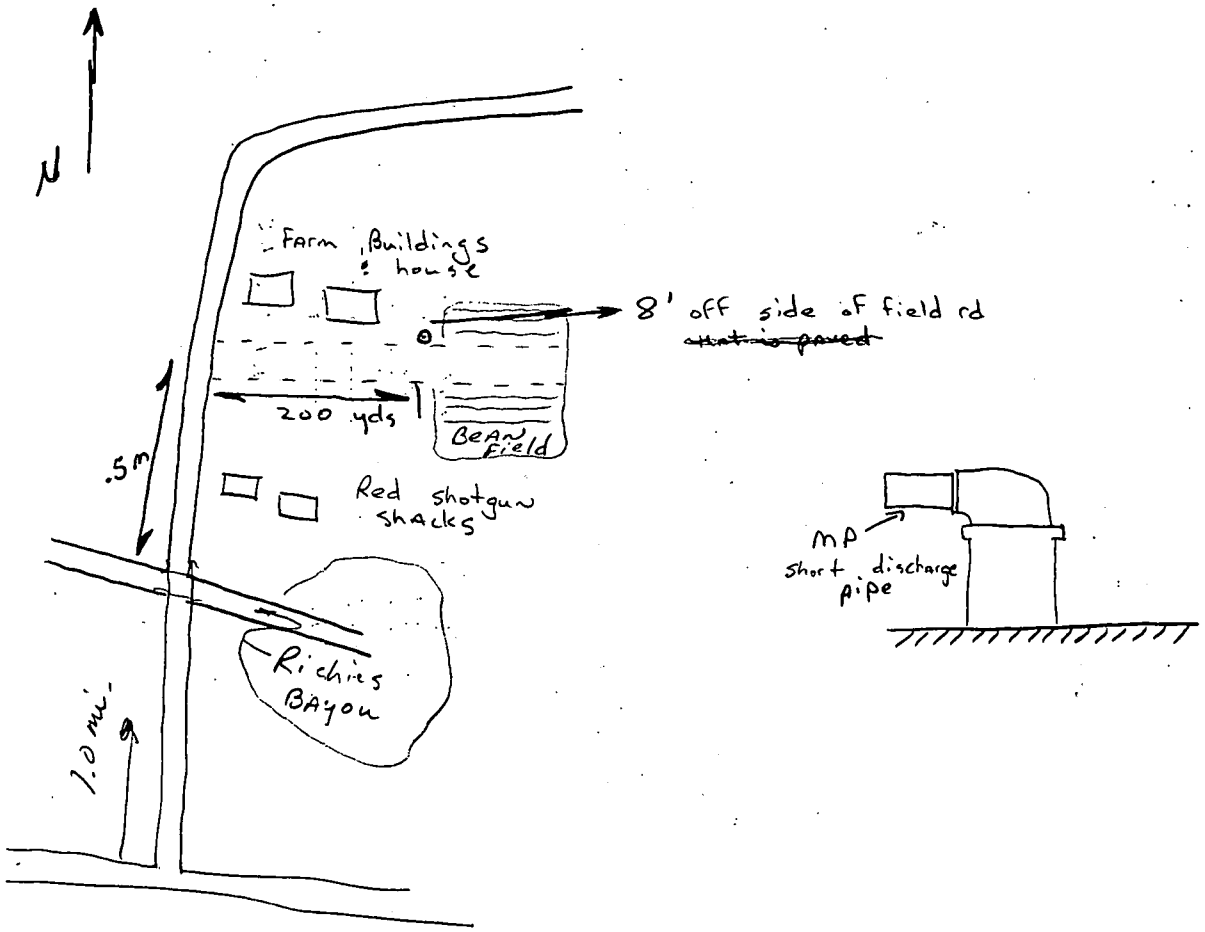
N
Farm Buildings & house
8' off side of field rd
~~that is paved~~
200 yds
Bean Field
.5 m
Red shotgun shacks
Richies Bayou
1.0 mi.
MP
short discharge pipe

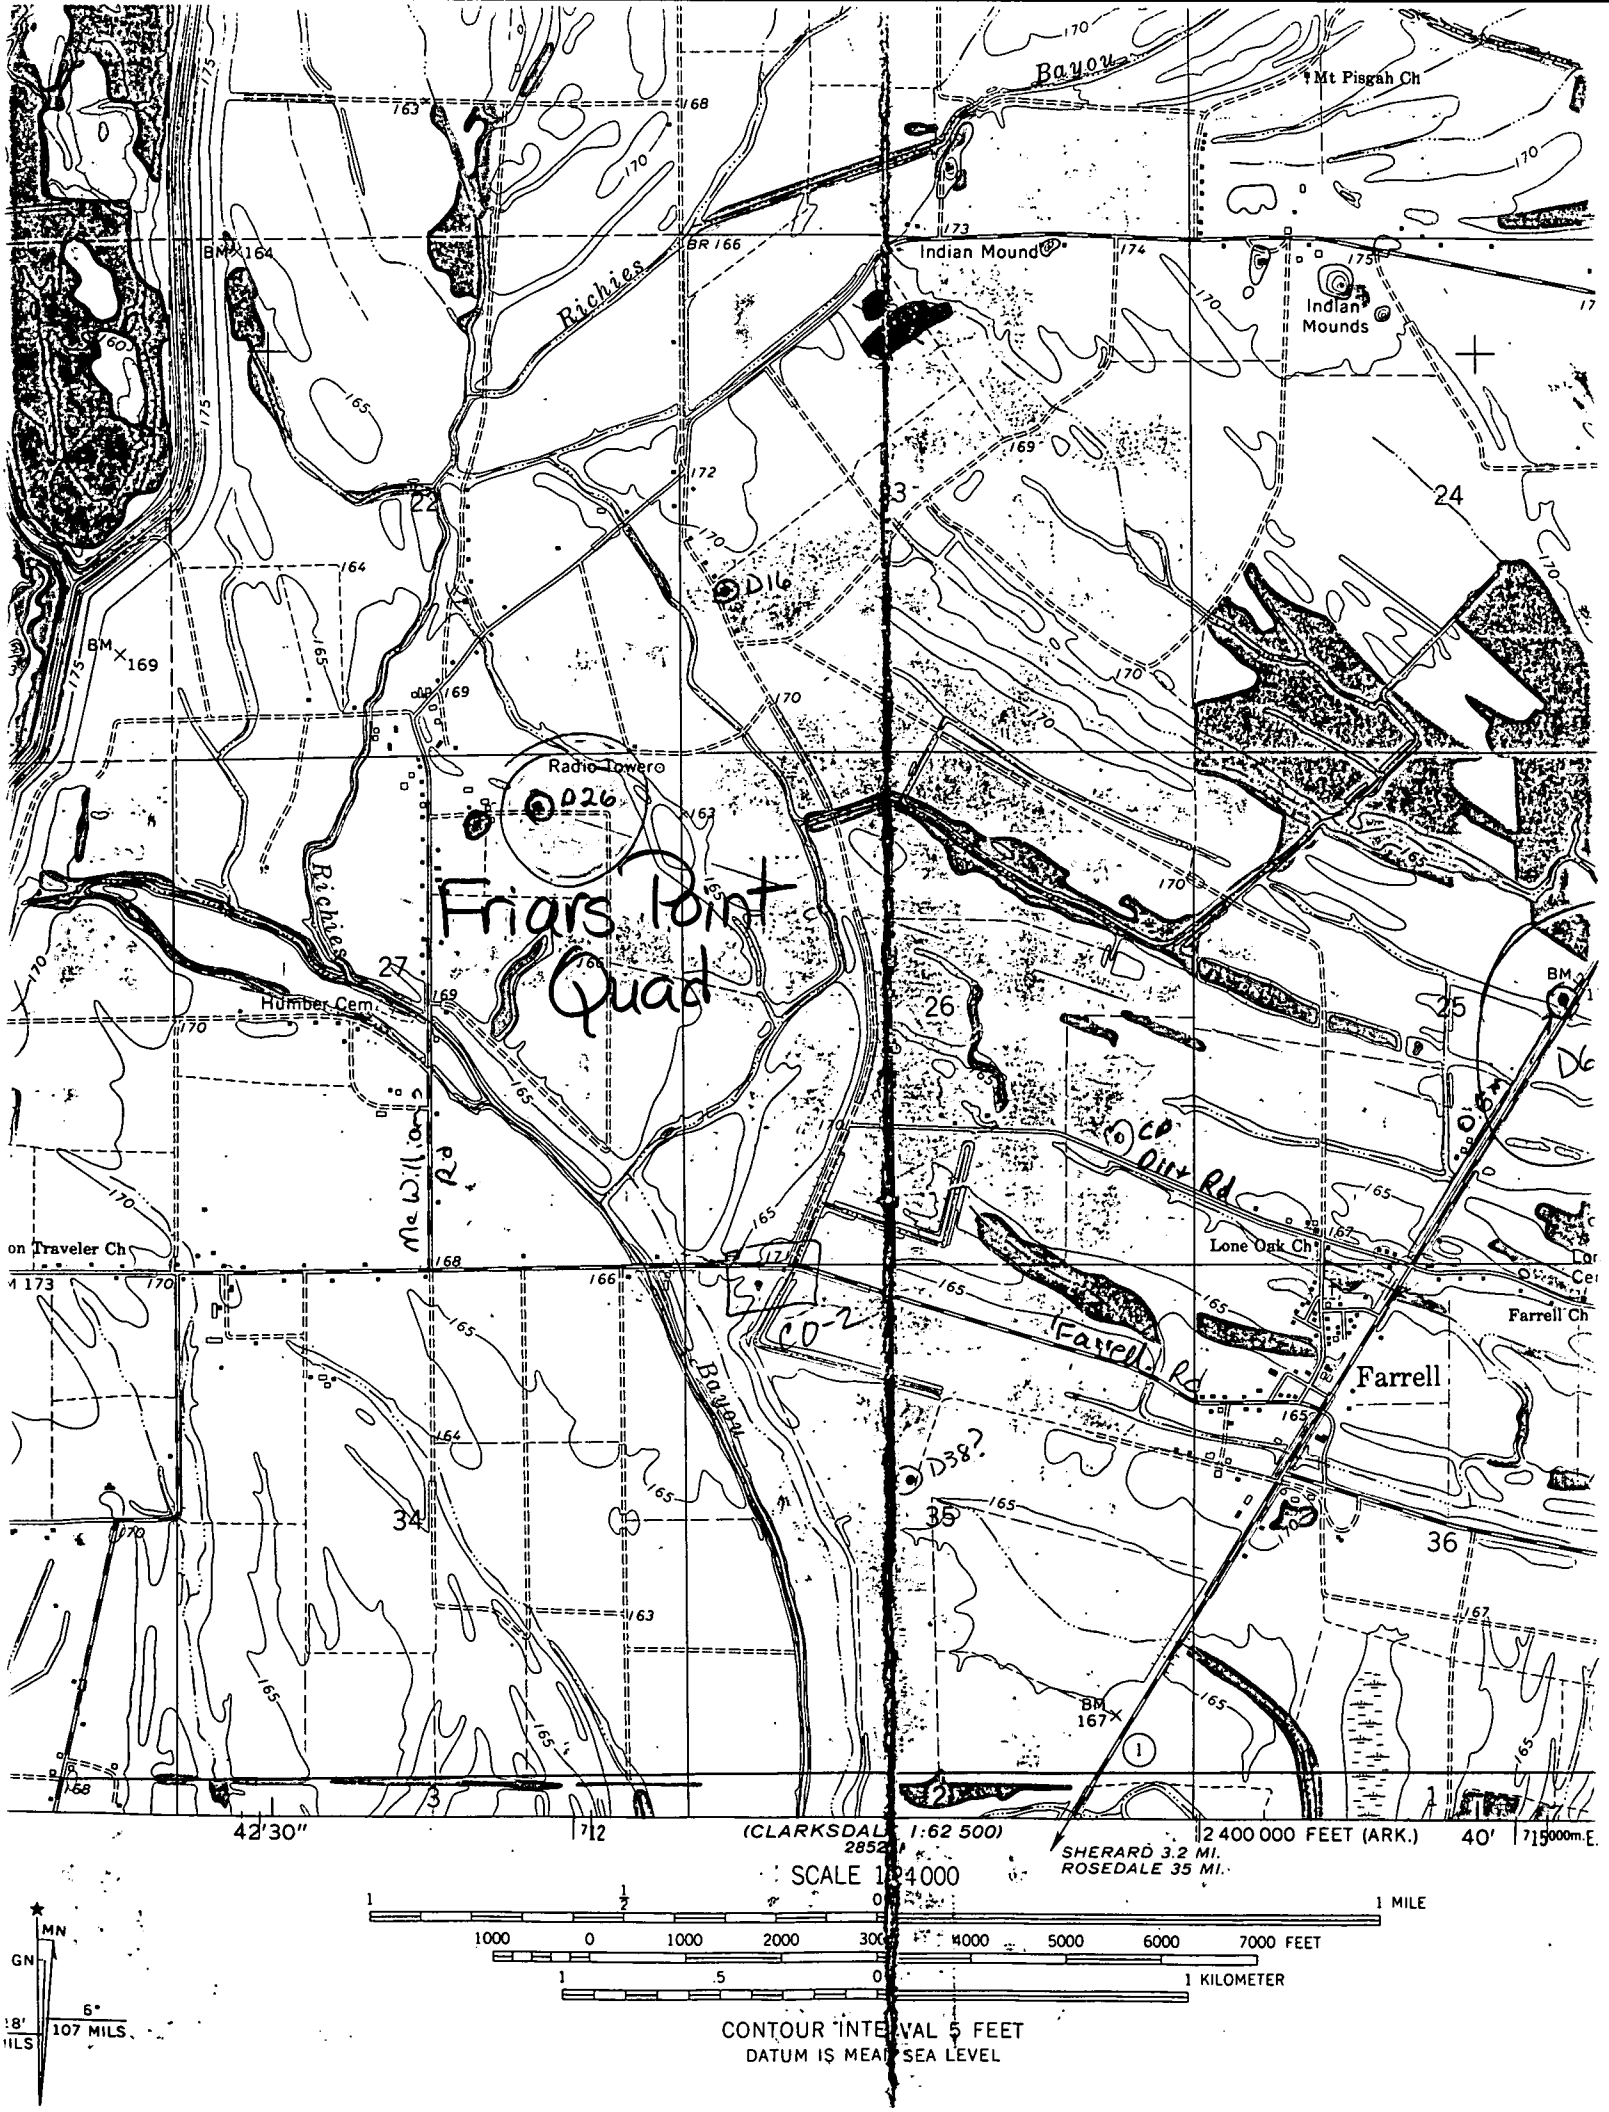
Bayou
Mt Pisgah Ch
Indian Mound
Indian Mounds
Richies
BR 166
BM 164
BM 169
Radio Tower
D16
D26
Friars Point Quad
Humber Cem.
McWilliams Rd
Richies
Lone Oak Ch
CO Dirt Rd
CO-2
Farrell Rd
Farrell
Farrell Ch
Bayou
D38?
BM 167
on Traveler Ch
22
3
24
27
26
25
34
35
36
42'30"
7 1/2
(CLARKSDALE 1:62 500)
2852
2 400 000 FEET (ARK.)
40'
7 15 000m E.
SHERARD 3.2 MI.
ROSEDALE 35 MI.
SCALE 1:24000
1 MILE
1000 0 1000 2000 3000 4000 5000 6000 7000 FEET
1 .5 0 1 KILOMETER
MN
GN
6°
107 MILS
CONTOUR INTERVAL 5 FEET
DATUM IS MEAN SEA LEVEL